


CHANNEL PF-1 STRETCH 5			
Existing Channel Condition (Input)			
Design Discharge	Q <sub>0</sub> =	20.8 cfs	
Design Discharge Return Period	Y <sub>ret</sub> =	25 years	
Existing Ground Slope Along Channel Centerline	So =	0.0266 ft/ft	
100-Year Discharge	Q <sub>100</sub> =	29.1 cfs	
Left Side Slope	Z1 =	4.0 ft/ft	
Right Side Slope	Z2 =	4.0 ft/ft	
Channel Manning's N (New Condition 030 yp.)	N <sub>new</sub> =	0.035	
Channel Manning's N (Mature Condition 040 yp.)	N <sub>mature</sub> =	0.035	
Check one of the following soil types			
Sandy Soil		<input checked="" type="checkbox"/> X	check, OR
Non-Sandy Soil		<input type="checkbox"/>	check
Proposed Channel Condition (Calculated)			
Bottom Width	B =	New Channel 4.0 ft	Mature Channel 4.0 ft
100-Year Flow Depth (S' maximum)	Y <sub>100</sub> =	1.22 ft	1.22 ft
100-Year Flow Velocity	V <sub>100</sub> =	4.9 fps	4.9 fps
100-Year Top Width	T =	9.8 ft	9.8 ft
100-Year Flow Area	A =	6.0 sq ft	6.0 sq ft
100-Year Froude Number	Fr =	1.10	1.10
100-Year Wetted Perimeter	P =	10.1 ft	10.1 ft
100-Year Hydraulic Radius	R =	0.6 ft	0.6 ft
Design Discharge Flow Depth	Y <sub>0</sub> =	1.08 ft	1.08 ft
Design Discharge Flow Velocity	V <sub>0</sub> =	4.5 fps	4.5 fps
Design Discharge Top Width	T =	8.6 ft	8.6 ft
Design Discharge Flow Area	A =	4.6 sq ft	4.6 sq ft
Design Discharge Froude Number	Fr =	1.08	1.08
Design Discharge Wetted Perimeter	P =	8.9 ft	8.9 ft
Design Discharge Hydraulic Radius	R =	0.5 ft	0.5 ft
Drop Height			
Proposed New Channel Slope	Sd =	0.0266 ft/ft	0.0266 ft/ft
Drop Height per 100 ft	D =	0.0 ft/100 ft	0.0 ft/100 ft

CHANNEL PF-2 STRETCH 6			
Existing Channel Condition (Input)			
Design Discharge	Q <sub>0</sub> =	20.0 cfs	
Design Discharge Return Period	Y <sub>ret</sub> =	2 years	
Existing Ground Slope Along Channel Centerline	So =	0.0120 ft/ft	
100-Year Discharge	Q <sub>100</sub> =	98.8 cfs	
Left Side Slope	Z1 =	4.0 ft/ft	
Right Side Slope	Z2 =	4.0 ft/ft	
Channel Manning's N (New Condition 030 yp.)	N <sub>new</sub> =	0.030	
Channel Manning's N (Mature Condition 040 yp.)	N <sub>mature</sub> =	0.040	
Check one of the following soil types			
Sandy Soil		<input checked="" type="checkbox"/> X	check, OR
Non-Sandy Soil		<input type="checkbox"/>	check
Proposed Channel Condition (Calculated)			
Bottom Width	B =	New Channel 4.0 ft	Mature Channel 4.0 ft
100-Year Flow Depth (S' maximum)	Y <sub>100</sub> =	2.22 ft	2.48 ft
100-Year Flow Velocity	V <sub>100</sub> =	5.0 fps	4.0 fps
100-Year Top Width	T =	17.8 ft	19.8 ft
100-Year Flow Area	A =	19.8 sq ft	24.5 sq ft
100-Year Froude Number	Fr =	0.84	0.64
100-Year Wetted Perimeter	P =	18.3 ft	20.4 ft
100-Year Hydraulic Radius	R =	1.1 ft	1.2 ft
Design Discharge Flow Depth	Y <sub>0</sub> =	1.22 ft	1.36 ft
Design Discharge Flow Velocity	V <sub>0</sub> =	3.4 fps	2.7 fps
Design Discharge Top Width	T =	9.8 ft	10.9 ft
Design Discharge Flow Area	A =	6.0 sq ft	7.4 sq ft
Design Discharge Froude Number	Fr =	0.76	0.58
Design Discharge Wetted Perimeter	P =	10.1 ft	11.2 ft
Design Discharge Hydraulic Radius	R =	0.6 ft	0.7 ft
Drop Height			
Proposed New Channel Slope	Sd =	0.0092 ft/ft	0.0092 ft/ft
Drop Height per 100 ft	D =	0.3 (negligible) ft/100 ft	0.3 ft/100 ft

NOTE: ACTUAL DEPTH OF CONSTRUCTED CHANNELS WILL BE 2.5 TO ALLOW FOR FREEBOARD.

\*NOTE: DATA DEVELOPED AND PRESENTED IN THIS TABLE IS BASED ON THE PROPOSED CHANNEL DESIGN. NO SURVEY DATA WAS AVAILABLE.


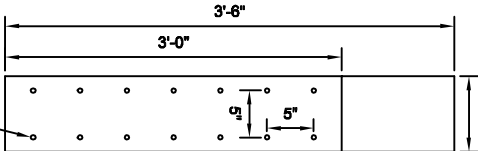


### PERFORATION DETAILS FOR STAND PIPE

NTS

Channel	Q100 (cfs)	Hd (feet)	Drop number	Ld (feet)	Yp (feet)	Y1 (feet)	Y2 (feet)	L (feet)
PF-2	14.05	3.88	0.00	21.79	11.32	0.23	8.41	72.25

\*NOTE: NO SURVEY DATA WAS PROVIDED FOR DROP STRUCTURE. STRUCTURE WAS ASSUMED TO BE BUILT ACCORDING TO PLAN. CALCULATIONS IN TABLE ARE NOT BASED ON AS-BUILT DATA.

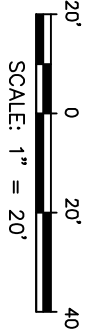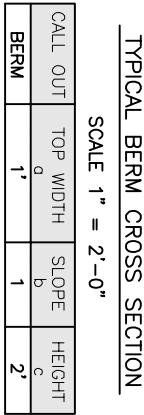

AS-BUILT DRAWING

### AS-BUILT

These as-built plans are based on the information compiled and furnished by others. The compiled information represented on these drawings is not intended to represent in detail the exact location, type or component nor manner of construction.



Tetra Tech Inc.

DESIGNED BY: CAW  
DRAWN BY: DMF  
CHECKED BY: MRR

RE-CHECKED BY: TLS  
APPROVED BY: RG  
DATE: 05/21/2008

SIZE D  
IF SHEET IS LESS  
THAN 22" X 34"  
IT IS A REDUCED  
PRINT  
SCALE REDUCED  
ACCORDINGLY

Prepared for:



TONY M MINE  
PHASE 1 SEDIMENT BASIN  
AS-BUILT

Tony M Mine

Garfield County, Utah

EXHIBIT

G-5

SYMBOL	DESCRIPTION	PREP. BY	DATE	APPROVED
REVISIONS				